


Tp.62, R.28, W.4M.
LOCATION PLAN
 SCALE = 1:40,000

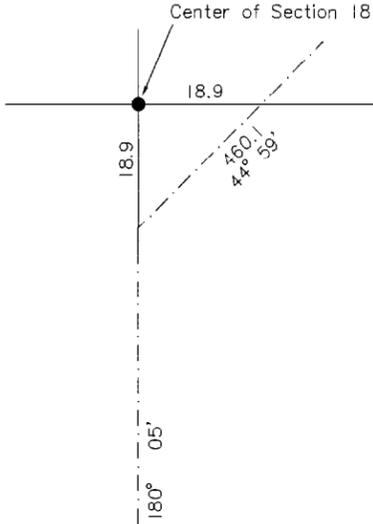

LEAVE SPACE FOR RECORD DETAILS
 5 X 20 CENTIMETRES

SPECIMEN ONLY

PLAN SHOWING
 AS - BUILT LOCATION of
GAS LINE
 IN
 PRAIRIE INDIAN RESERVE No. 151
 Township 62 Range 28 W.4M.
 Province of Alberta

LEGEND

Bearings are derived (copied) from the monuments marking the east boundary of Lot 3, Block 1 as shown on Plan 65000 CLSR and are referred to the Central Meridian through Tp.62, R.28, W.4M.


Monuments found ●
 Traverse lines - - - - -

Distances are in metres.
 Gas Line is within 2.0 metres of either side of the traverse line.
 Gas Line was located using a ferromagnetic pipe locator.

Certified Correct

J.J. McARTHUR, CLS, March 1, 1993.

ADD APPROPRIATE ENDORSMENT CERTIFICATES

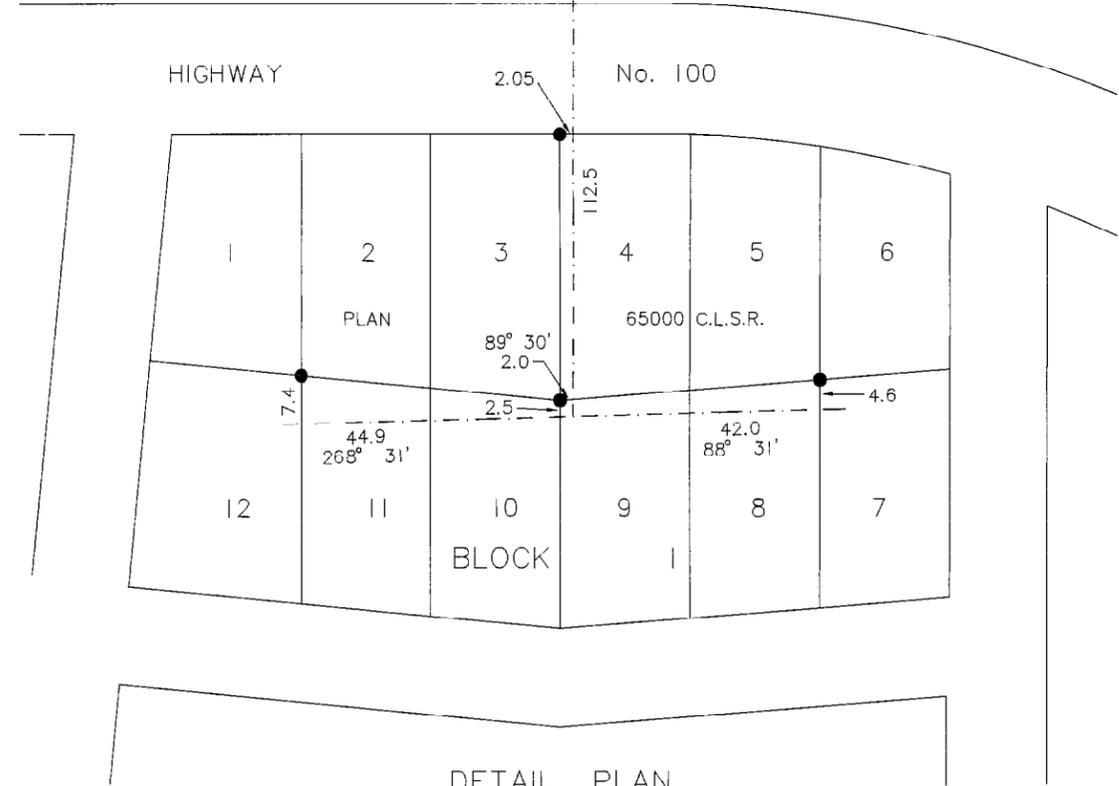

DETAIL PLAN
 SCALE = 1:1000